


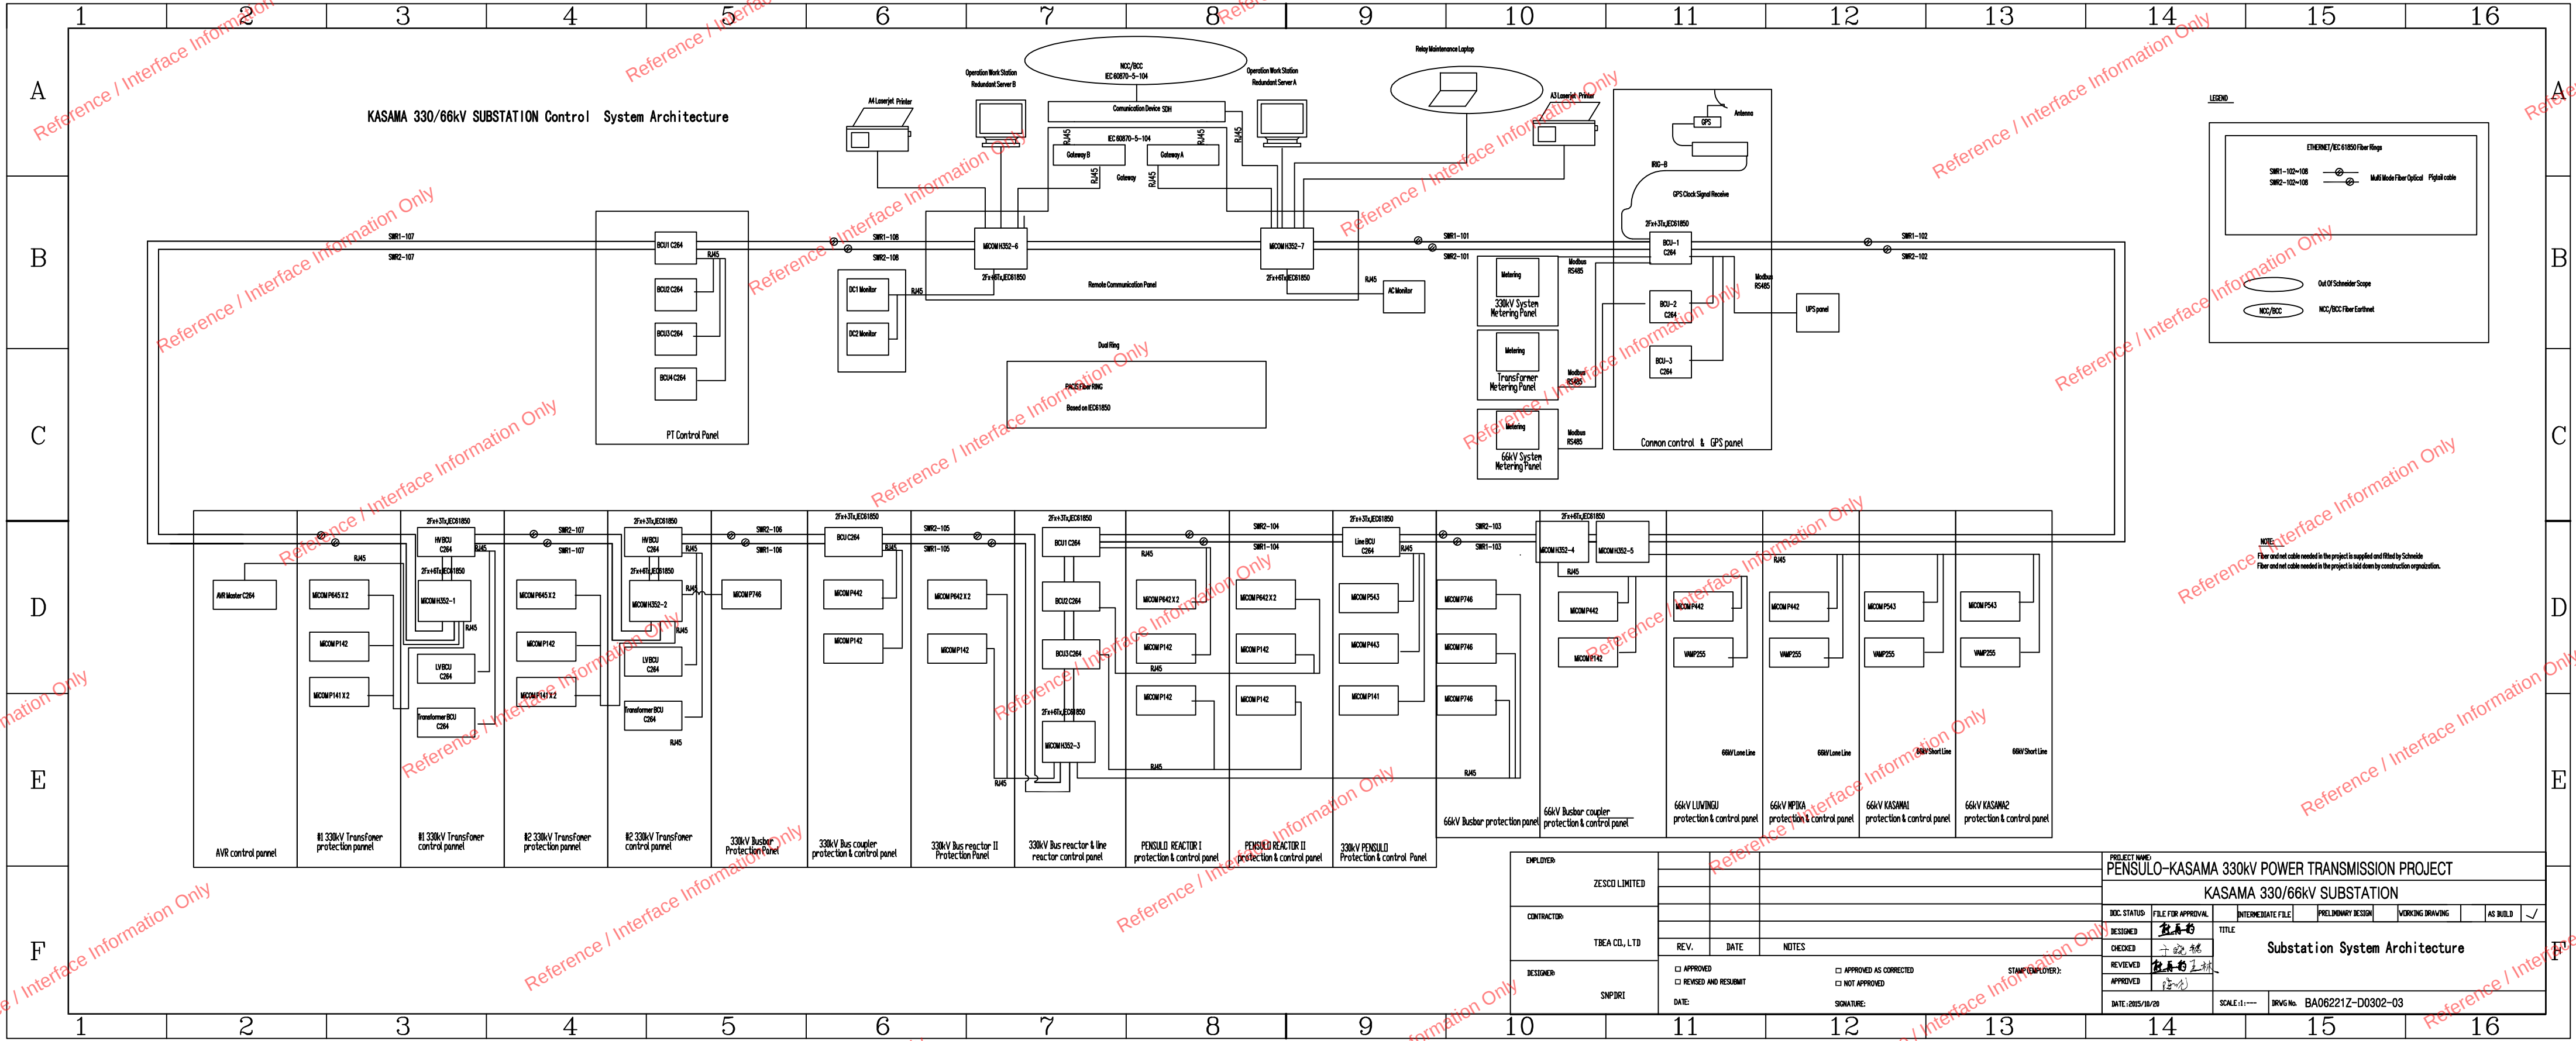

EMPLOYER	ZESCO LIMITED			PROJECT NAME: PENSULO-KASAMA 330kV POWER TRANSMISSION PROJECT									
				KASAMA 330/66kV SUBSTATION									
CONTRACTOR	TBEA CO., LTD			DOC. STATUS	FILE FOR APPROVAL	INTERMEDIATE FILE	PRELIMINARY DESIGN	WORKING DRAWING	AS BUILT	✓			
				DESIGNED	12.12.20	TITLE Substation System Architecture							
DESIGNER	SNPDR			☐ APPROVED		☐ APPROVED AS CORRECTED		STAMP (EMPLOYER):					
				☐ REVISED AND RESUBMIT		☐ NOT APPROVED							
				DATE:		SIGNATURE:		DATE: 2025/10/20		SCALE: 1:1		DWG No: BA08221Z-D0302-03	